



LEGEND

- Botter line
- 4.83 Certified Finished surface level

NOTES

1. All batters with allotments are a maximum of 1:6 unless noted otherwise.

6.0m wide overland flow tip out behind Pit 1G, transition back to 3% verge X-fall over 10m each side.

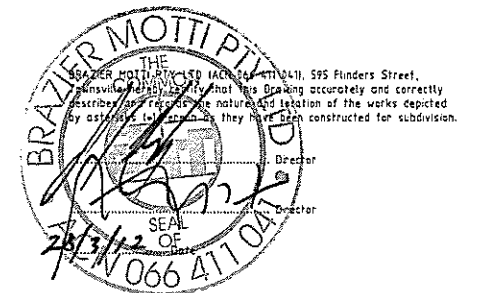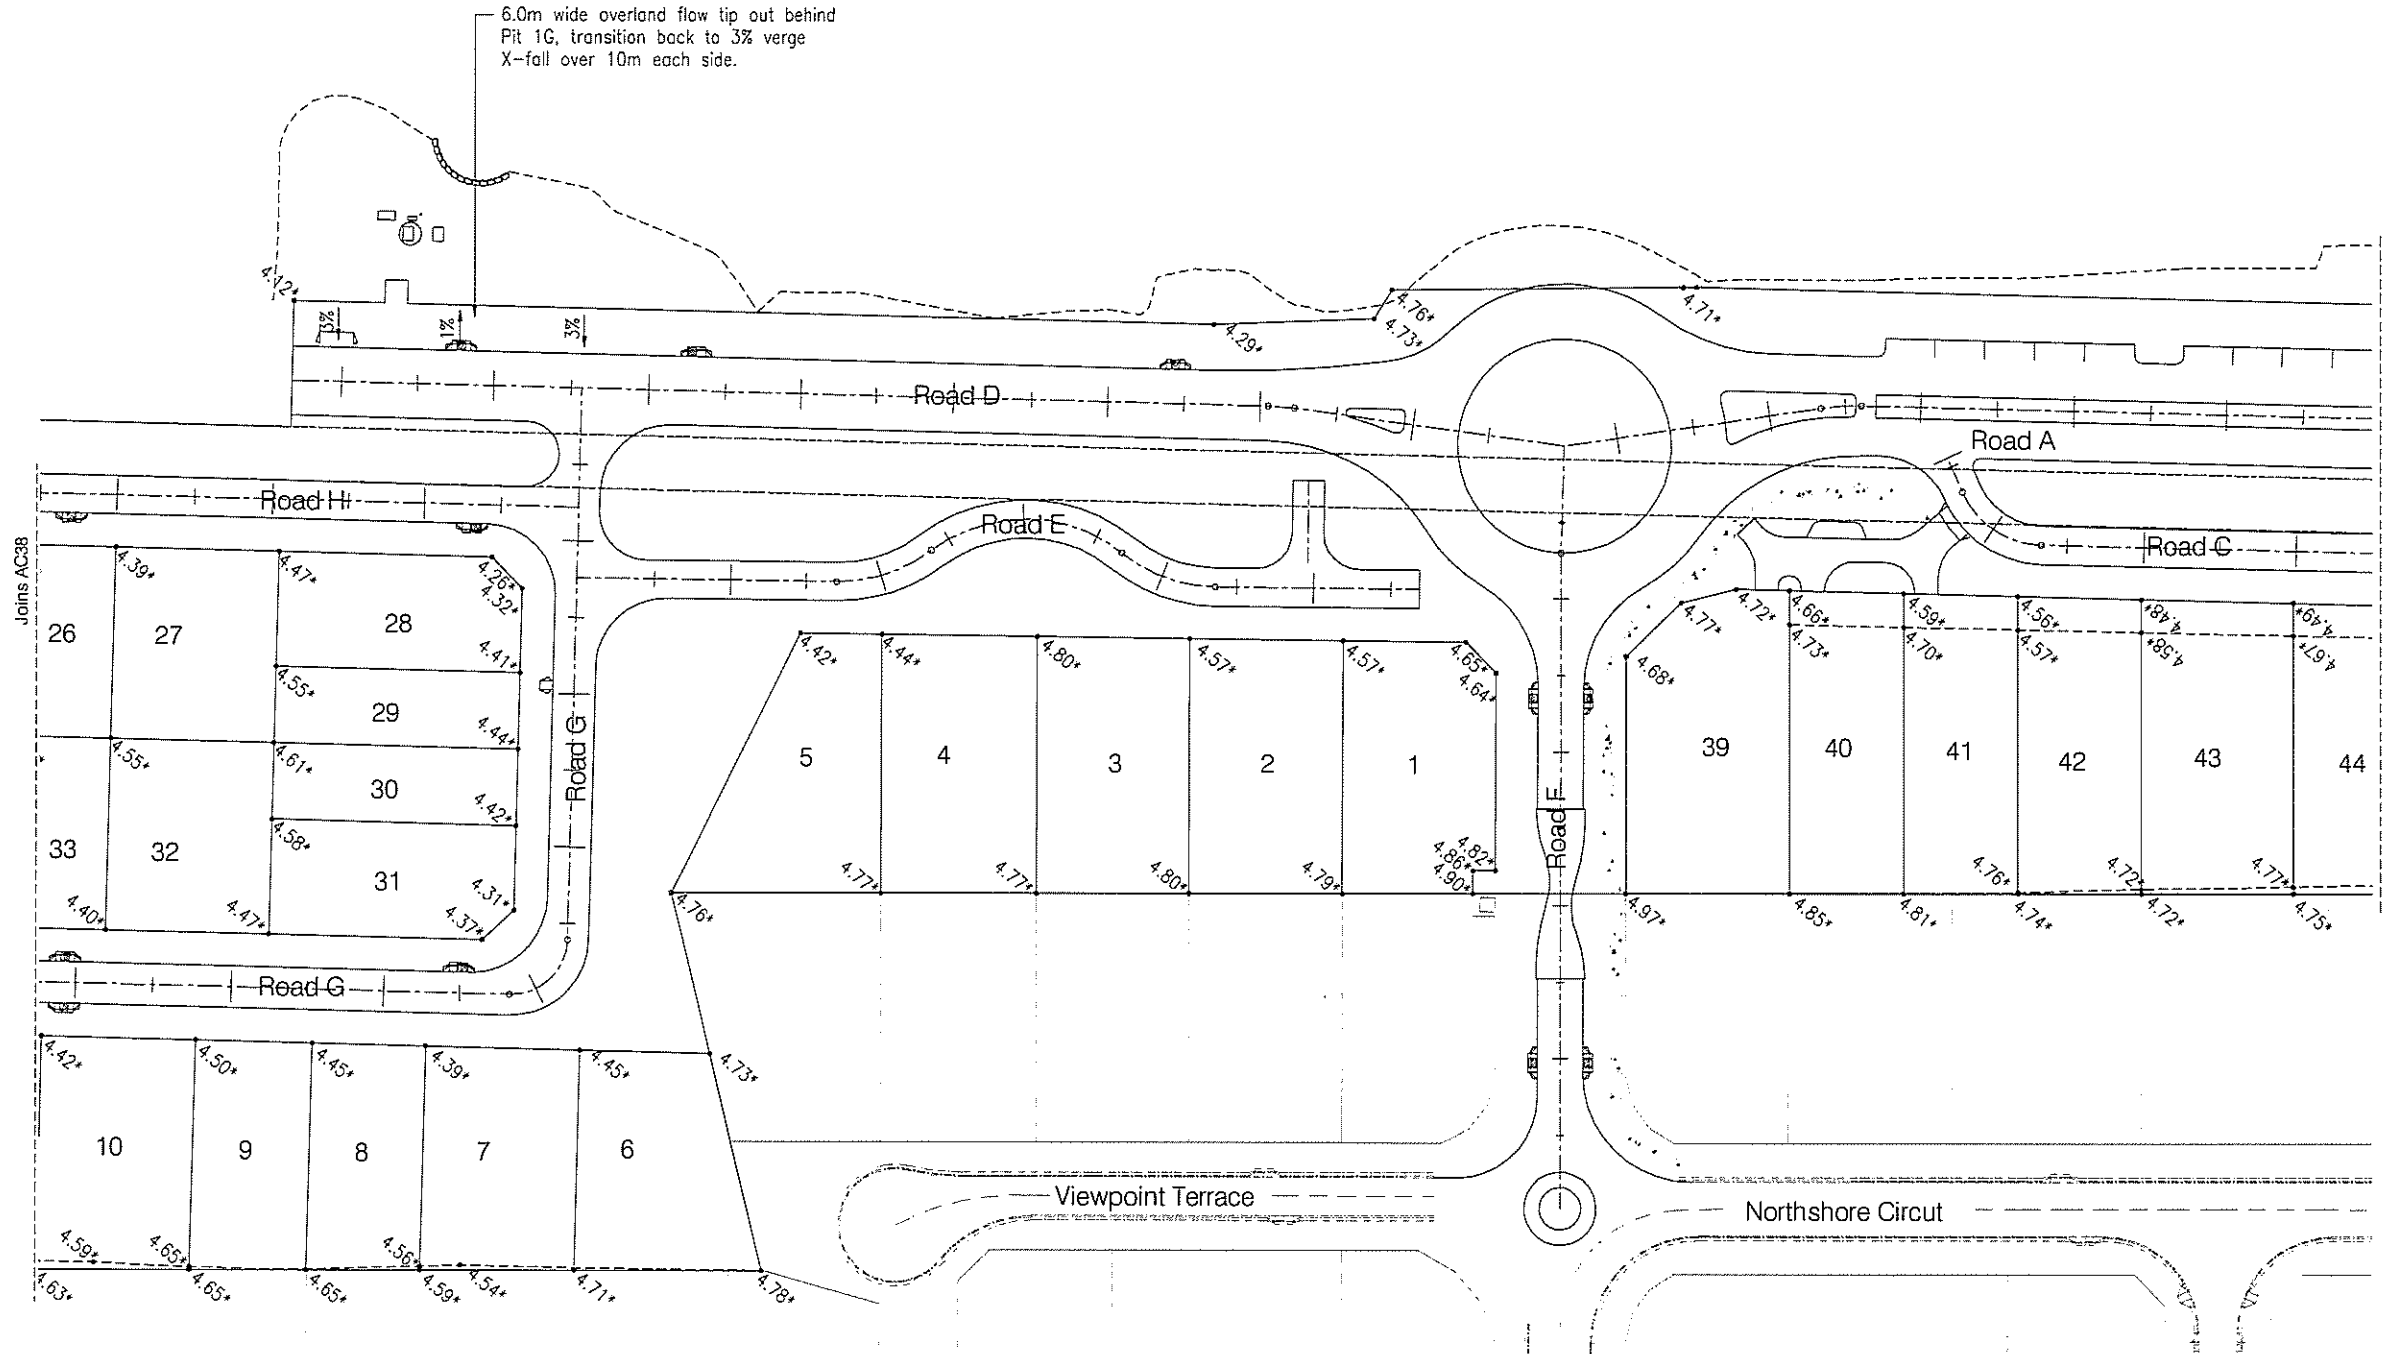

REV	DESCRIPTION	TASK MAN	APPROVED	RPEO No.	DATE
A	AS CONSTRUCTED ISSUE			9396	28/03/12

THIS DRAWING IS COPYRIGHT AND THE PROPERTY OF FLANAGAN CONSULTING GROUP, A REGISTERED BUSINESS NAME OF SOUTH PACIFIC SANDS PTY. LTD. (ACN 052 933 887) AND MUST NOT BE REPRODUCED WITHOUT WRITTEN PERMISSION.

ASSOCIATED CONSULTANTS


**brazier motti**  
www.braziermotti.com.au  
595 Flinders Street, Townsville  
Phone: 4772 1144 Fax: 4772 2557  
Email: townsville@braziermotti.com.au  
Job No: 29060/018-01

CLIENT / PROJECT

**OONOONBA**  
Stage 1

**FLANAGAN CONSULTING GROUP**  
7TH FLOOR CENTRAL PLAZA  
370 FLINDERS STREET MALL TOWNSVILLE  
P.O. BOX 891 TOWNSVILLE, QLD. 4810  
PHONE: 07 4724 5727  
FAX: 07 4721 4684  
EMAIL: townsville@fcg.com.au  
WEB: www.fcg.com.au

DESIGNED	TITLE	
DRAWN	ALLOTMENT GRADING PLAN	
SW	A1 FULL SIZE	REVISION
ACAD No.		A
5625-AC36-38 DWG	DRAWING No.	5625-AC37
SCALE	SHEET 37 OF 54 SHEETS	
1:500		

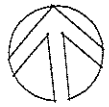



LEGEND

- Batter line
- Certified Finished surface level

NOTES

1. All batters with allotments are a maximum of 1:6 unless noted otherwise.

6.0m wide overland flow tip out behind Pit 1G, transition back to 3% verge X-fall over 6.0m each side.

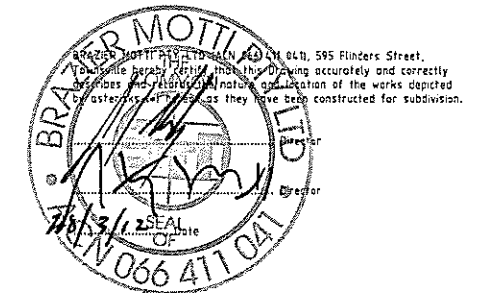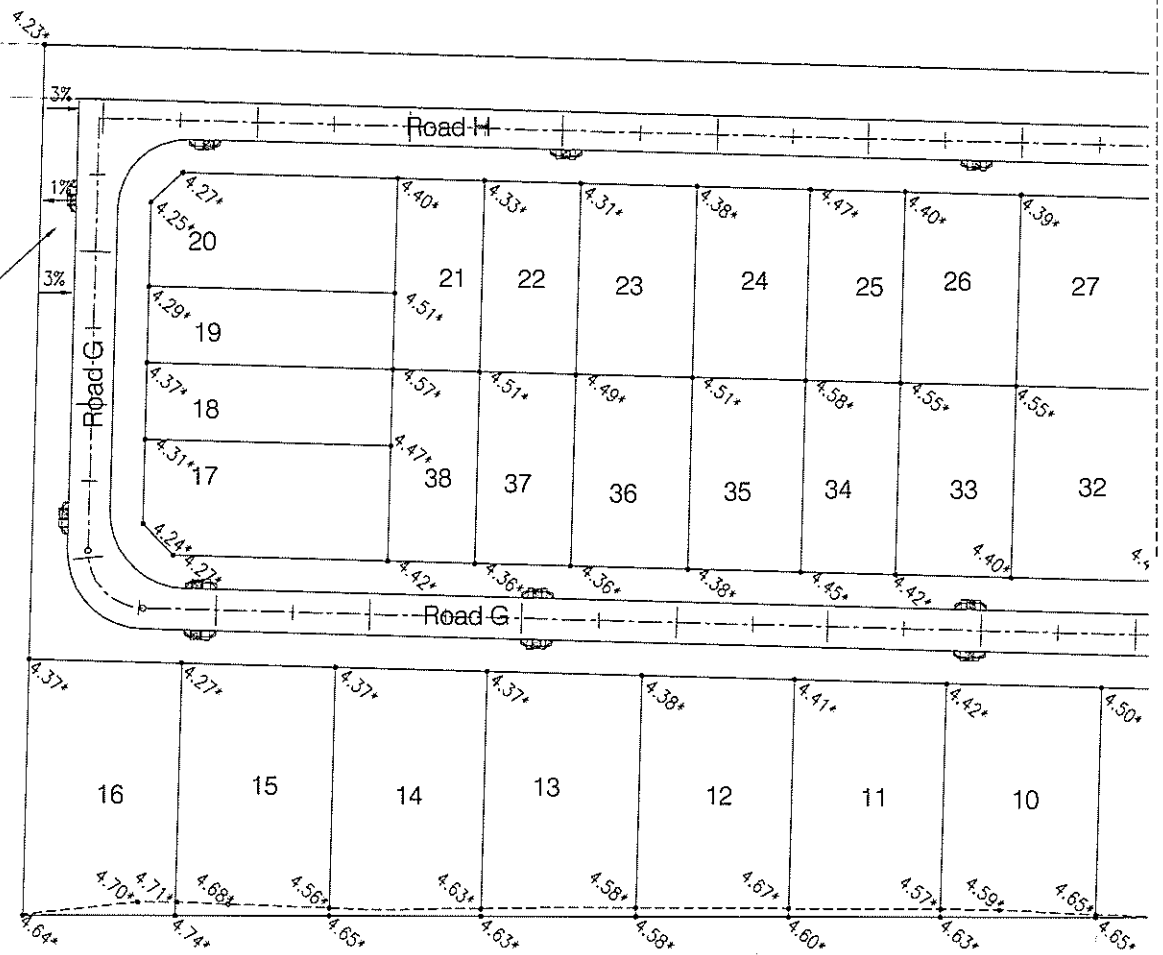

REV	DESCRIPTION	TASK MAN	APPROVED	RPEQ No.	DATE
A	AS CONSTRUCTED ISSUE			9396	28/03/12

THIS DRAWING IS COPYRIGHT AND THE PROPERTY OF FLANAGAN CONSULTING GROUP, A REGISTERED BUSINESS NAME OF SOUTH PACIFIC SANDS PTY. LTD. (ACN 052 933 667) AND MUST NOT BE REPRODUCED WITHOUT WRITTEN PERMISSION.

ASSOCIATED CONSULTANTS

**brazier motti**  
www.braziermotti.com.au  
595 Flinders Street, Townsville  
Phone: 4772 1144 Fax: 4772 2557  
Email: townsville@braziermotti.com.au  
Job No: 29060/018-01

CLIENT / PROJECT

**OONOONBA**  
Stage 1

**FLANAGAN CONSULTING GROUP**  
7TH FLOOR CENTRAL PLAZA  
370 FLINDERS STREET MALL TOWNSVILLE  
P.O. BOX 891 TOWNSVILLE QLD 4810  
PHONE 07 4724 5737  
FAX 07 4721 4684  
EMAIL: townsville@fcggroup.com.au  
WEB: www.fcggroup.com.au

DESIGNED	TITLE	REVISION
SW	ALLOTMENT GRADING PLAN	A
ACAD No. 5625-AC36-38.DWG	DRAWING No. 5625-AC38	SHEET 38 OF 54 SHEETS
SCALE 1:500	A1 FULL SIZE	