



APPROVED PAVEMENT DESIGN
HOLYOAK AVENUE CH.20.000 - CH.94.567

30mm ASPHALT SURFACING (DG10)
 100mm BASE COURSE (DMR TYPE 2.1)
 100mm SUB-BASE COURSE (DMR TYPE 2.3)
 100mm LOWER SUB-BASE (DMR TYPE 2.5)

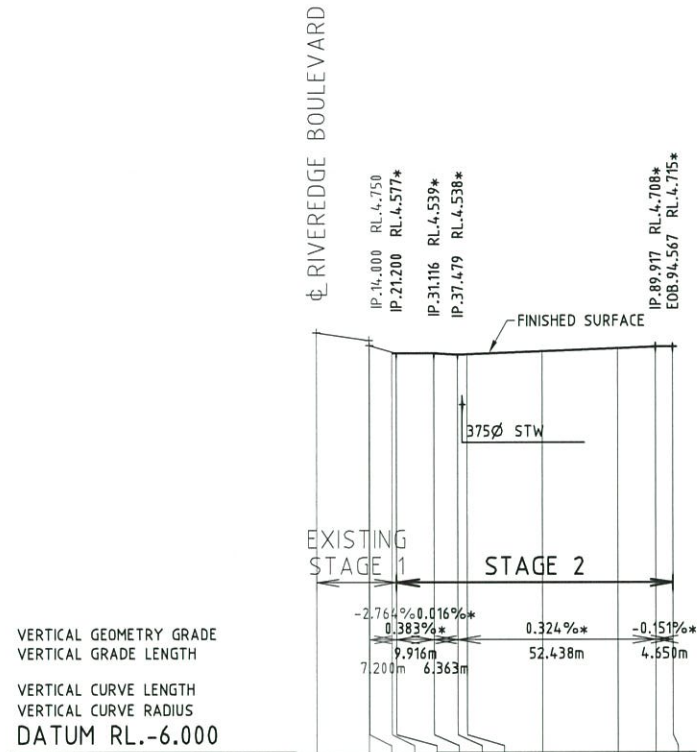


LIP OF KERB LEVELS RHS			4.447*	4.423*	4.429*	4.516*	4.592*	4.618*	4.603*
LIP OF KERB LEVELS LHS		REFER NOTE 1	4.459*	4.471*	4.473*	4.510*	4.588*	4.614*	4.603*
LIP OF KERB GRADE RHS %			0.377*	0.238*	0.435*	0.380*	0.262*	0.366*	
LIP OF KERB GRADE LHS %			0.660*	0.238*	0.435*	0.390*	0.262*	0.237*	
CONTROL LINE FINISHED LEVEL		5.100	4.900	4.750	4.584	4.571*	4.539*	4.538*	4.541*
CONTROL LINE CHAINAGE		00	13.850	14.000	20	21.200	31.116	37.479	40
SPEED	DESIGN	50 km/hr (EXCLUDING INTERSECTIONS)							
	REGULATORY	50 km/hr							


HOLYOAK AVENUE LONGITUDINAL SECTION
 SCALE 1:100 VERTICAL, SCALE 1:1000 HORIZONTAL

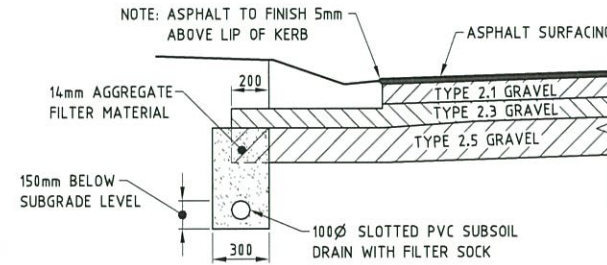

SUBSOIL AND KERB DETAIL
 SCALE 1:20

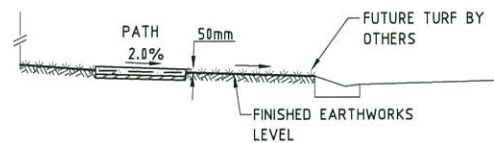

TYPICAL CONCRETE PATH SECTION
 SCALE 1:50

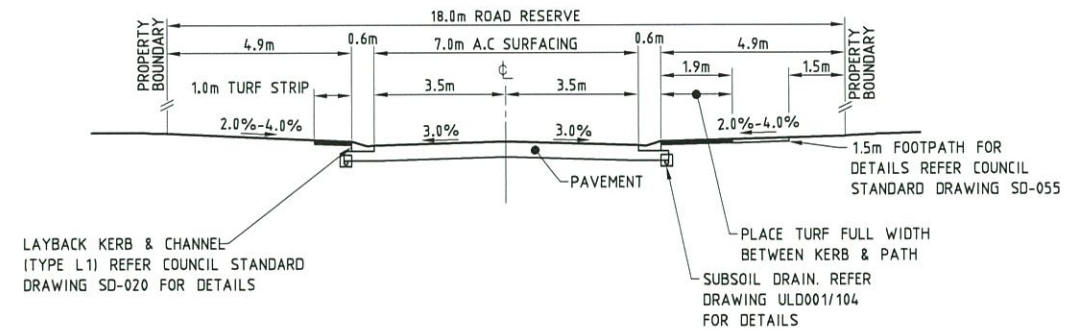



HOLYOAK TYPICAL CROSS SECTION
 SCALE 1:100 VERTICAL

NOTES:

- REFER ROADWORKS DETAILS PLAN DRAWINGS ULD001/105 FOR DETAILS.

BRAZIER MOTTI PTY LTD (ACN 066 411 104), 595 Flinders Street, Townsville hereby certify that this Drawing accurately and correctly describes and records the nature and location of the works depicted by asterisks (*) inasmuch as they have been constructed for subdivision.

Director
 Director
 Date: 4/7/13

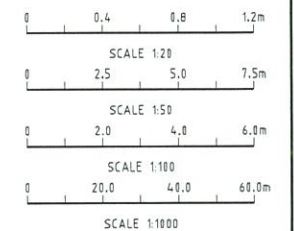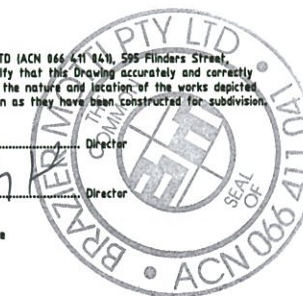

AS CONSTRUCTED ISSUE	
REV.	DATE
A	04/04/13 AS CONSTRUCTED ISSUE

brazier motti
 www.braziermotti.com.au
 595 Flinders Street, Townsville
 Phone: 4772 1144 Fax: 4772 2557
 Email: townsville@braziermotti.com.au
 Job No: 29060/028-02

REAL PROPERTY DESCRIPTION:
 LOT 7000 ON SP 247154

DRAWN: S.ROSSO	DATUM: AHD (DERIVED)
DESIGNED:	PSM 78108
	RL.3.081
CHECKED: P.MURPHY	
PROJECT MANAGER: P.PETERSEN	PROJECT DIRECTOR: P.BRADY RPEQ 7112

UDP Consulting Engineers
 Urban Development Design Infrastructure Project Management
 Level 1, 62 Walker Street
 TOWNSVILLE QLD 4810
 PO BOX 1110
 TOWNSVILLE QLD 4810

Phone: (07) 4772 0686
 Fax: (07) 4772 0586
 Email: main@udpconsulting.com.au
 Web: www.udpconsulting.com.au

URBAN LAND DEVELOPMENT AUTHORITY
 THE VILLAGE - STAGE 2
 RIVEREDGE BOULEVARD, OONOONBA
 HOLYOAK AVENUE LONGITUDINAL & TYPICAL CROSS SECTIONS

DRAWING SIZE	SCALE	AS SHOWN	DRAWING No.	REV
A1	XREF	-	ULD001/103	A