


APPROVED PAVEMENT DESIGN


GOODE LANE

170mm THICK N32 CONCRETE, SL82 MESH 50mm TOP COVER
 150mm SUB BASE COURSE (DMR TYPE 2.3)
 PAVEMENT FEATURE REFER ULDD01/106


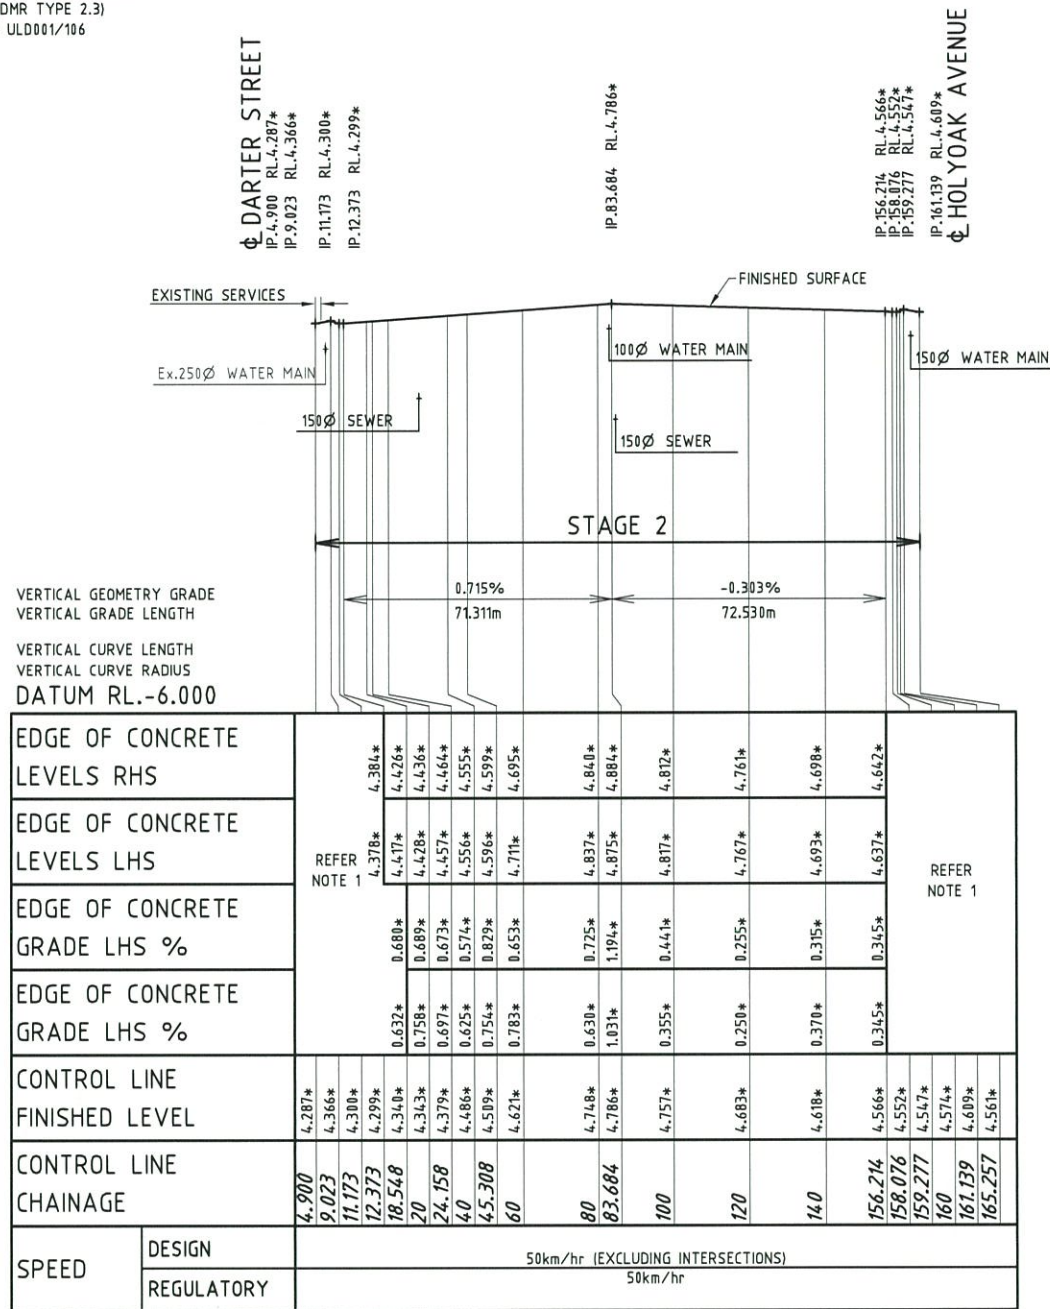


GOODE LANE LONGITUDINAL SECTION

SCALE 1:100 VERTICAL, SCALE 1:1000 HORIZONTAL

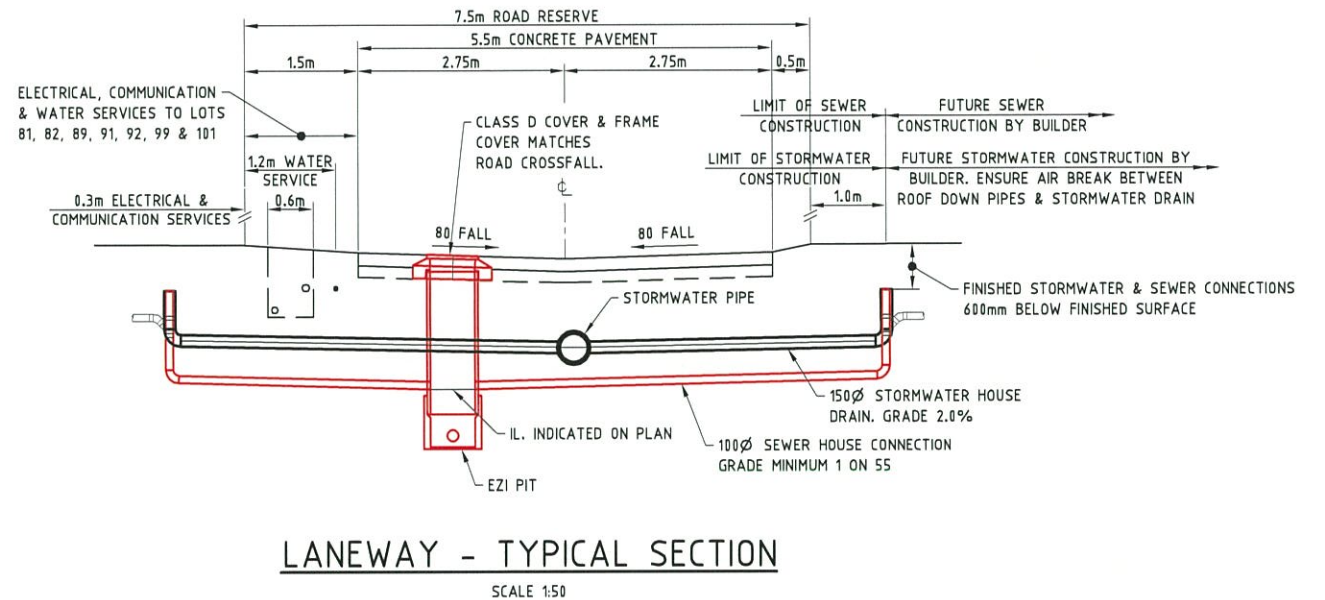

BRAZIER MOTTI PTY LTD (ACN 866 411 041), 595 Flinders Street, Townsville hereby certifies that this Drawing accurately and correctly describes and records the nature and location of the works depicted by asterisks (*) herein as they have been constructed for subdivision.

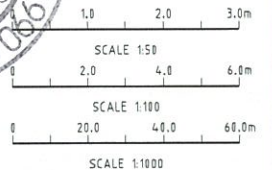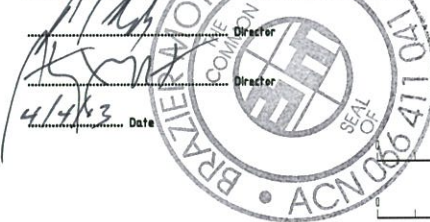

NOTES:

- REFER ROADWORKS DETAILS PLAN DRAWINGS ULDD01/105 FOR DETAILS.

AS CONSTRUCTED ISSUE

brazier motti
 www.braziermotti.com.au
 595 Flinders Street, Townsville
 Phone: 4772 1144 Fax: 4772 2557
 Email: townsville@braziermotti.com.au
 Job No: 29060/028-02

REAL PROPERTY DESCRIPTION:
 LOT 7000 ON SP 24.7154
 DRAWN: S.ROSSO
 DESIGNED: P.MURPHY
 CHECKED: P.MURPHY
 PROJECT MANAGER: P.PETERSEN
 DATUM: AHD (DERIVED)
 PSM 78108
 RL.3.081
 PROJECT DIRECTOR: P.BRADY RPEQ 7112

UDP Consulting Engineers
 Urban Development Design Infrastructure Project Management
 Level 1, 62 Walker Street
 TOWNVILLE QLD 4810
 PO BOX 1110
 TOWNVILLE QLD 4810
 Phone: (07) 4772 0666
 Fax: (07) 4772 0566
 Email: main@udpconsulting.com.au
 Web: www.udpconsulting.com.au

URBAN LAND DEVELOPMENT AUTHORITY
 THE VILLAGE - STAGE 2
 RIVEREDGE BOULEVARD, OONOONBA
 GOODE LANE LONGITUDINAL & TYPICAL CROSS SECTIONS
 DRAWING SIZE: A1
 SCALE: XREF
 AS SHOWN
 DRAWING No. ULD001/104
 REV A