


**ROADWORKS DETAILS**  
SCALE 1:200

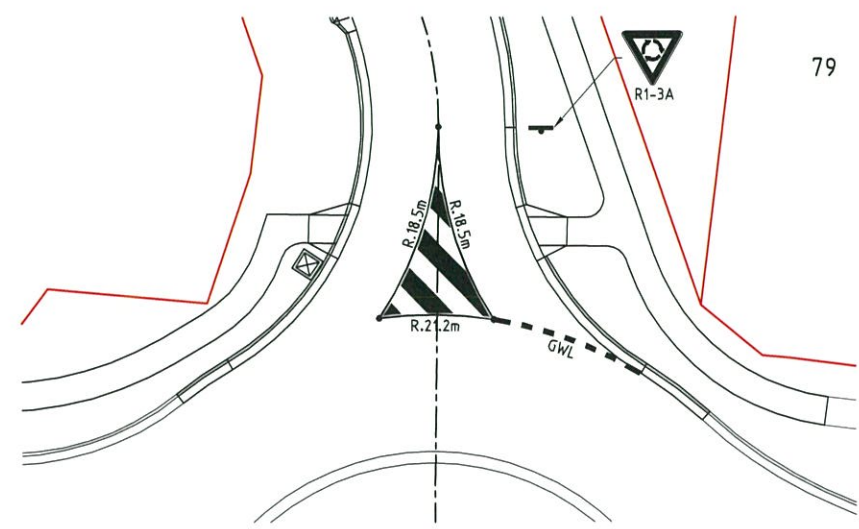

**LINEMARKING DETAILS**  
SCALE 1:200

**LINEMARKING LEGEND**

REFERENCE	LINE TYPE
GWL	GIVE WAY LINE 
ULL	UNBROKEN LANE LINE 

- NOTES**
- ALL LINEMARKING, SIGNAGE AND PLACEMENT OF RRPMS ARE IN ACCORDANCE WITH M.U.T.C.D.
  - ALL LINEMARKING IS TO BE WHITE PAINT UNLESS NOTED OTHERWISE.

BRAZIER MOTTI PTY LTD IACN 866 411 841, 595 Flinders Street, Townsville hereby certify that this Drawing accurately and correctly describes and records the nature and location of the works depicted by asterisks (\*) hereon as they have been constructed for subdivision.

9/14/13 Date

Director


Director

SCALE 1:100

SCALE 1:200

- LEGEND**
- LAYBACK KERB & CHANNEL (TYPE L1)
  - BARRIER KERB & CHANNEL (TYPE B1)

- NOTES:**
- ALL LEVEL INFORMATION IS TO LIP OF KERB UNLESS OTHERWISE STATED.

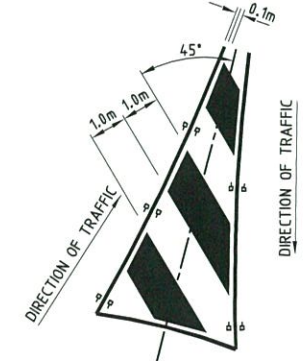

**TYPICAL CHEVRON MARKING**  
SCALE 1:100

Δ DENOTES WHITE UNI-DIRECTIONAL R.R.P.M.'S, LOCATED CENTRALLY BETWEEN DIAGONALLY PAINTED MARKINGS IN EVERY SPACE.

**AS CONSTRUCTED ISSUE**

REV.	DATE	REVISIONS
A	04/04/13	AS CONSTRUCTED ISSUE

**brazier motti**  
www.braziermotti.com.au

595 Flinders Street, Townsville  
Phone: 4772 1144 Fax: 4772 2557  
Email: townsville@braziermotti.com.au  
Job No: 29060/028-02

**REAL PROPERTY DESCRIPTION:**  
LOT 7000 ON SP 247154

<b>DRAWN:</b> S.ROSSO	<b>DATUM:</b> AHD (DERIVED)
<b>DESIGNED:</b>	PSM 78108 RL.3.081
<b>CHECKED:</b> P.MURPHY	
<b>PROJECT MANAGER:</b> P.PETERSEN	<b>PROJECT DIRECTOR:</b> P.BRADY RPEQ 7112

**UDP Consulting Engineers**

Urban Development Design Infrastructure Project Management

Level 1, 62 Walker Street  
TOWNSVILLE QLD 4810  
PO BOX 1110  
TOWNSVILLE QLD 4810

Phone: (07) 4772 0666  
Fax: (07) 4772 0566  
Email: main@udpconsulting.com.au  
Web: www.udpconsulting.com.au

**URBAN LAND DEVELOPMENT AUTHORITY**

THE VILLAGE - STAGE 2  
RIVEREDGE BOULEVARD, OONOONBA  
ROADWORKS DETAILS PLAN - SHEET 1 OF 2

<b>DRAWING SIZE</b> A1	<b>SCALE</b> AS SHOWN XREF ULD001-XR-ASCON	<b>DRAWING No.</b> ULD001/105	<b>REV</b> A
---------------------------	--	----------------------------------	-----------------