


LOCALITY PLAN
NTS

DRAWING SCHEDULE

DRAWING NO.	NAME
CONSTRUCTION SET DRAWINGS	
ULD003/100	LOCALITY PLAN, SITE PLAN & DRAWING SCHEDULE
ULD003/101	EARTHWORKS LAYOUT PLAN - SHEET 1 OF 2
ULD003/102	EARTHWORKS LAYOUT PLAN - SHEET 2 OF 2
ULD003/103	ROADWORKS & STORMWATER DRAINAGE PLAN
ULD003/104	MIZUNO VIEW & MAINWARING WAY LONGITUDINAL SECTIONS
ULD003/105	MIZUNO VIEW & MAINWARING WAY CROSS SECTIONS
ULD003/106	ROADWORKS DETAILS PLAN - SHEET 1 OF 2
ULD003/107	ROADWORKS DETAILS PLAN - SHEET 2 OF 2
ULD003/108	Q2 STORMWATER LONGITUDINAL SECTION
ULD003/109	WATER RETICULATION PLAN
ULD003/110	SEWERAGE RETICULATION PLAN

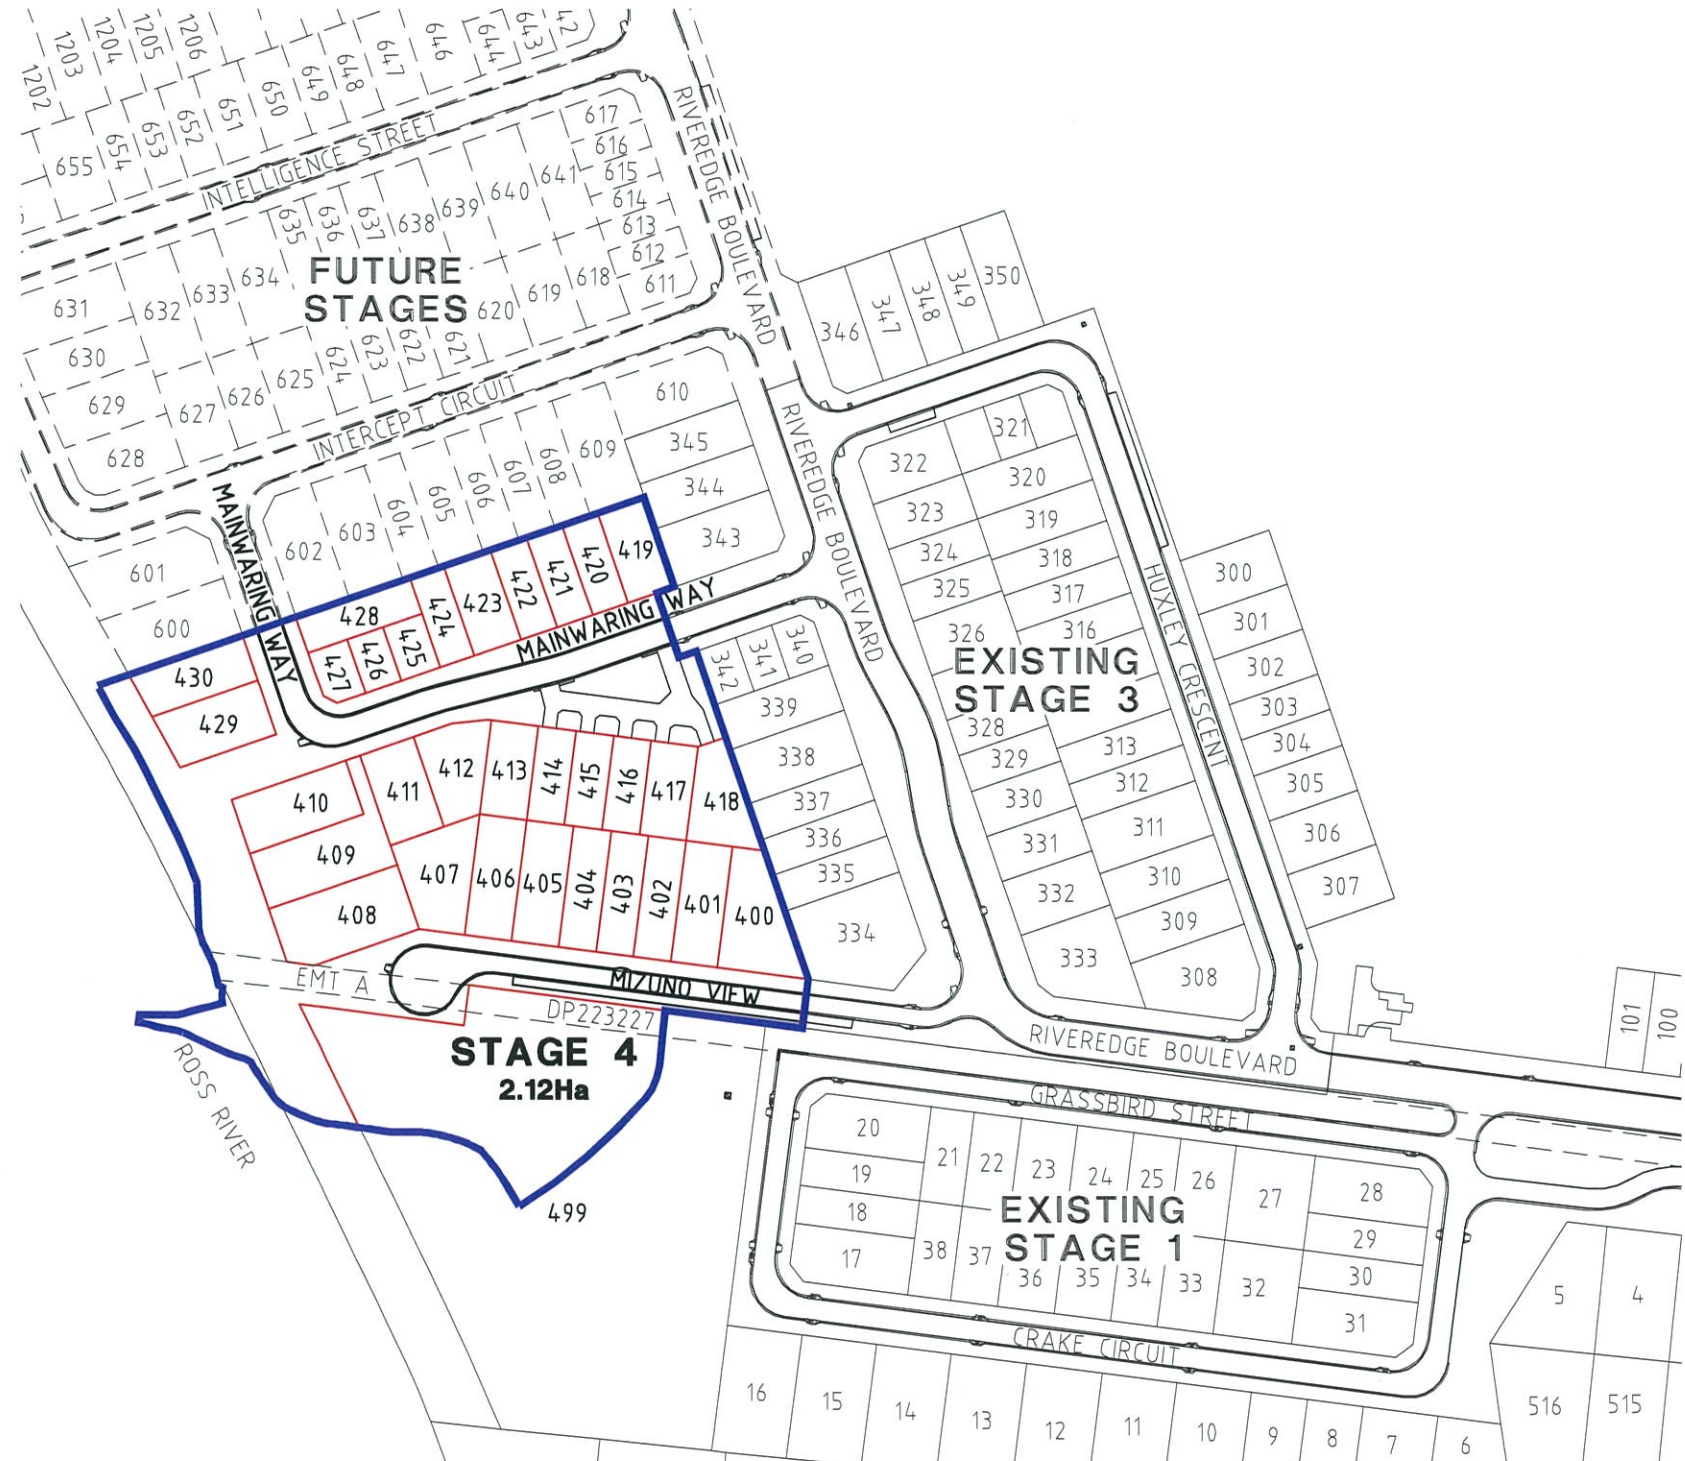

SITE PLAN
SCALE 1:1000



AS-CONSTRUCTED ISSUE

REV.	DATE	AS CONSTRUCTED ISSUE	REVISIONS
A	14/04/14	AS CONSTRUCTED ISSUE	

6:\19869\048-02 STAGE 4 AS CONS\ULD003-100.DWG

brazier motti
www.braziermotti.com.au

595 Flinders Street, Townsville
Phone: 4772 1144 Fax: 4772 2557
Email: townsville@braziermotti.com.au
Job No: 29060/048-02

REAL PROPERTY DESCRIPTION:
LOTS 400 TO 430, 499 & 9001 CANCELLING LOT 9001 ON SP264450

DRAWN: M.MOTTI	DATUM: AHD (DERIVED)
DESIGNED:	PSM 78108
CHECKED: L.SCHAUMBURG	RL.3.081
PROJECT MANAGER: P.PETERSEN	ABBOTT STREET
PROJECT DIRECTOR: S.MARTIN RPEQ 9114	

UDP Consulting Engineers

Urban Development Design Infrastructure Project Management

DELGETY PLACE
84 DENHAM STREET
PO BOX 1110
TOWNSVILLE QLD 4810

Phone: (07) 4772 0666
Fax: (07) 4772 0566
Email: main@udpconsulting.com.au
Web: www.udpconsulting.com.au

ECONOMIC DEVELOPMENT QUEENSLAND

THE VILLAGE - STAGE 4
RIVEREDGE BOULEVARD, OONONBA
LOCALITY PLAN, SITE PLAN & DRAWING SCHEDULE

DRAWING SIZE: A1	SCALE: 1:1000	DRAWING No.: ULD003/100	REV: A
----------------------------	-------------------------	-----------------------------------	------------------