




SUBSOIL AND KERB DETAIL
SCALE 1:20

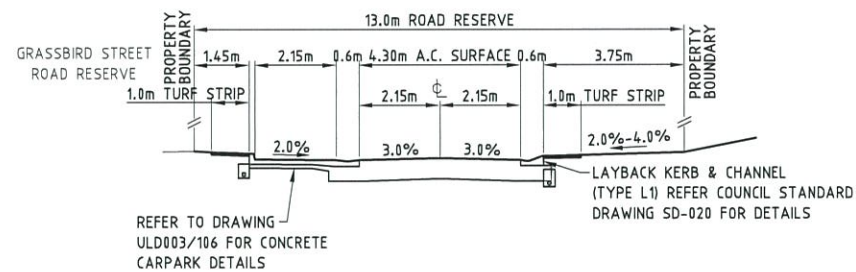



TYPICAL SECTION CH.50.909-CH.153.304
MIZUNO VIEW CROSS SECTION
SCALE 1:100

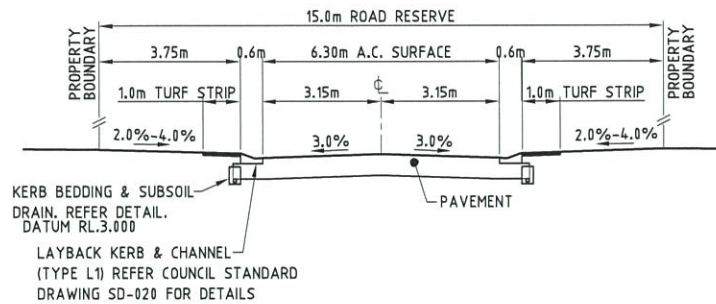

TYPICAL SECTION CH.120.000-CH.177.294

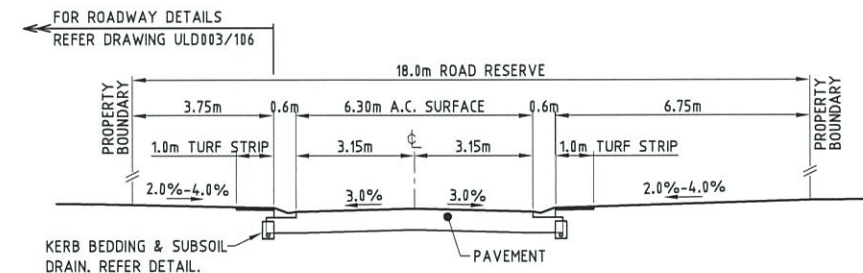

TYPICAL SECTION CH.49.400-CH.120.000
MAINWARING WAY CROSS SECTIONS
SCALE 1:100

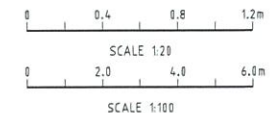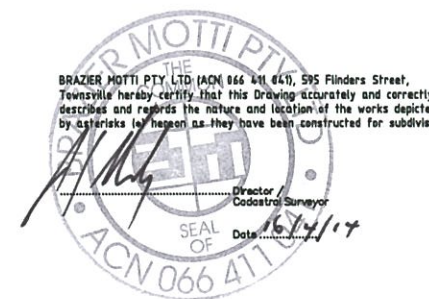

AS-CONSTRUCTED ISSUE

brazier motti
www.braziermotti.com.au
595 Flinders Street, Townsville
Phone: 4772 1144 Fax: 4772 2557
Email: townsville@braziermotti.com.au
Job No: 29060/048-02

REAL PROPERTY DESCRIPTION:
LOTS 400 TO 430, 499 & 9001 CANCELLING LOT 9001 ON SP264450
DRAWN: M.MOTTI
DESIGNED:
CHECKED: L.SCHAUMBURG
PROJECT MANAGER: P.PETERSEN
DATUM: AHD (DERIVED)
PSM 78108
RL.3.081
ABBOTT STREET
PROJECT DIRECTOR: S.MARTIN RPEQ 9114

UDP Consulting Engineers
Urban Development Design Infrastructure Project Management
DELGETY PLACE
84 DENHAM STREET
PO BOX 1110
TOWNSVILLE QLD 4810
Phone: (07) 4772 0666
Fax: (07) 4772 0566
Email: main@udpconsulting.com.au
Web: www.udpconsulting.com.au

ECONOMIC DEVELOPMENT QUEENSLAND
THE VILLAGE - STAGE 4
RIVEREDGE BOULEVARD, OONOONBA
MIZUNO VIEW & MAINWARING WAY CROSS SECTIONS
DRAWING No. **ULD003/105**
SCALE AS SHOWN
DRAWING SIZE A1
REV A