

**APPROVED PAVEMENT DESIGN**  
**MIZUNO VIEW CH.50.909-CH.60.000**

30mm ASPHALT SURFACING (DG10)  
 100mm BASE COURSE (DMR TYPE 2.1)  
 310mm SUB BASE COURSE (DMR TYPE 2.3)

**MIZUNO VIEW CH.60.000-CH.132.000**


30mm ASPHALT SURFACING (DG10)  
 100mm BASE COURSE (DMR TYPE 2.1)  
 150mm SUB BASE COURSE (DMR TYPE 2.3)

**MIZUNO VIEW CH.132.000-CH.140.000**

30mm ASPHALT SURFACING (DG10)  
 100mm BASE COURSE (DMR TYPE 2.1)  
 310mm SUB BASE COURSE (DMR TYPE 2.3)

**MIZUNO VIEW CH.140.000-CH.153.304**

30mm ASPHALT SURFACING (DG10)  
 100mm BASE COURSE (DMR TYPE 2.1)  
 150mm SUB BASE COURSE (DMR TYPE 2.3)

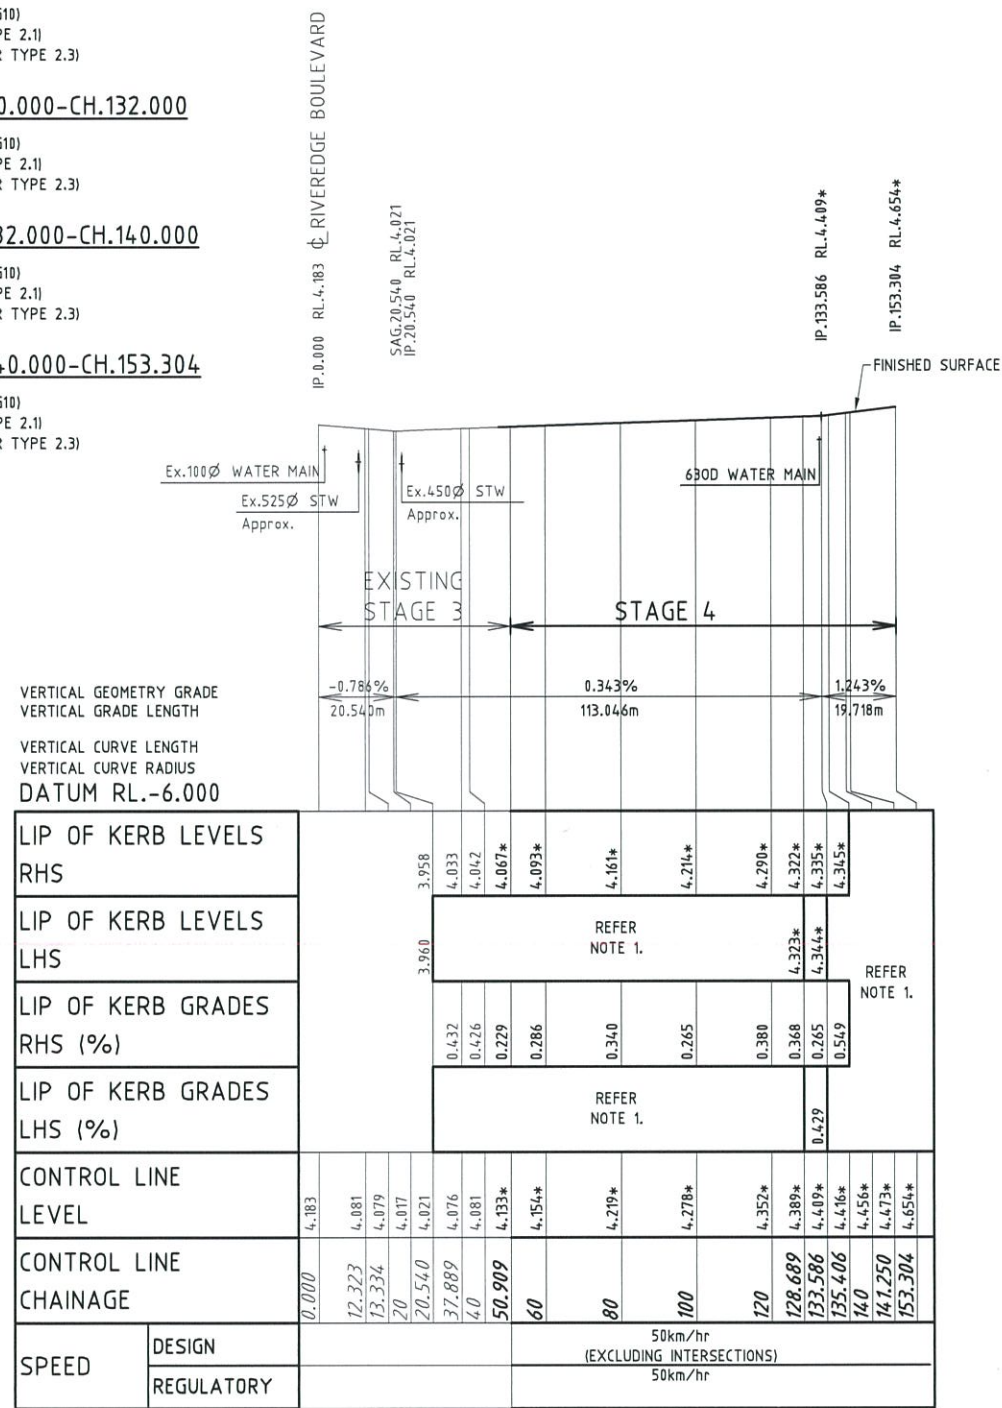


**MIZUNO VIEW LONGITUDINAL SECTION**  
 SCALE 1:100 VERTICAL, SCALE 1:1000 HORIZONTAL

**APPROVED PAVEMENT DESIGN**  
**MAINWARING WAY CH.49.400-CH.87.000**

30mm ASPHALT SURFACING (DG10)  
 100mm BASE COURSE (DMR TYPE 2.1)  
 350mm SUB BASE COURSE (DMR TYPE 2.3)

**MAINWARING WAY CH.CH.87.000-CH.177.294**

30mm ASPHALT SURFACING (DG10)  
 100mm BASE COURSE (DMR TYPE 2.1)  
 190mm SUB BASE COURSE (DMR TYPE 2.3)

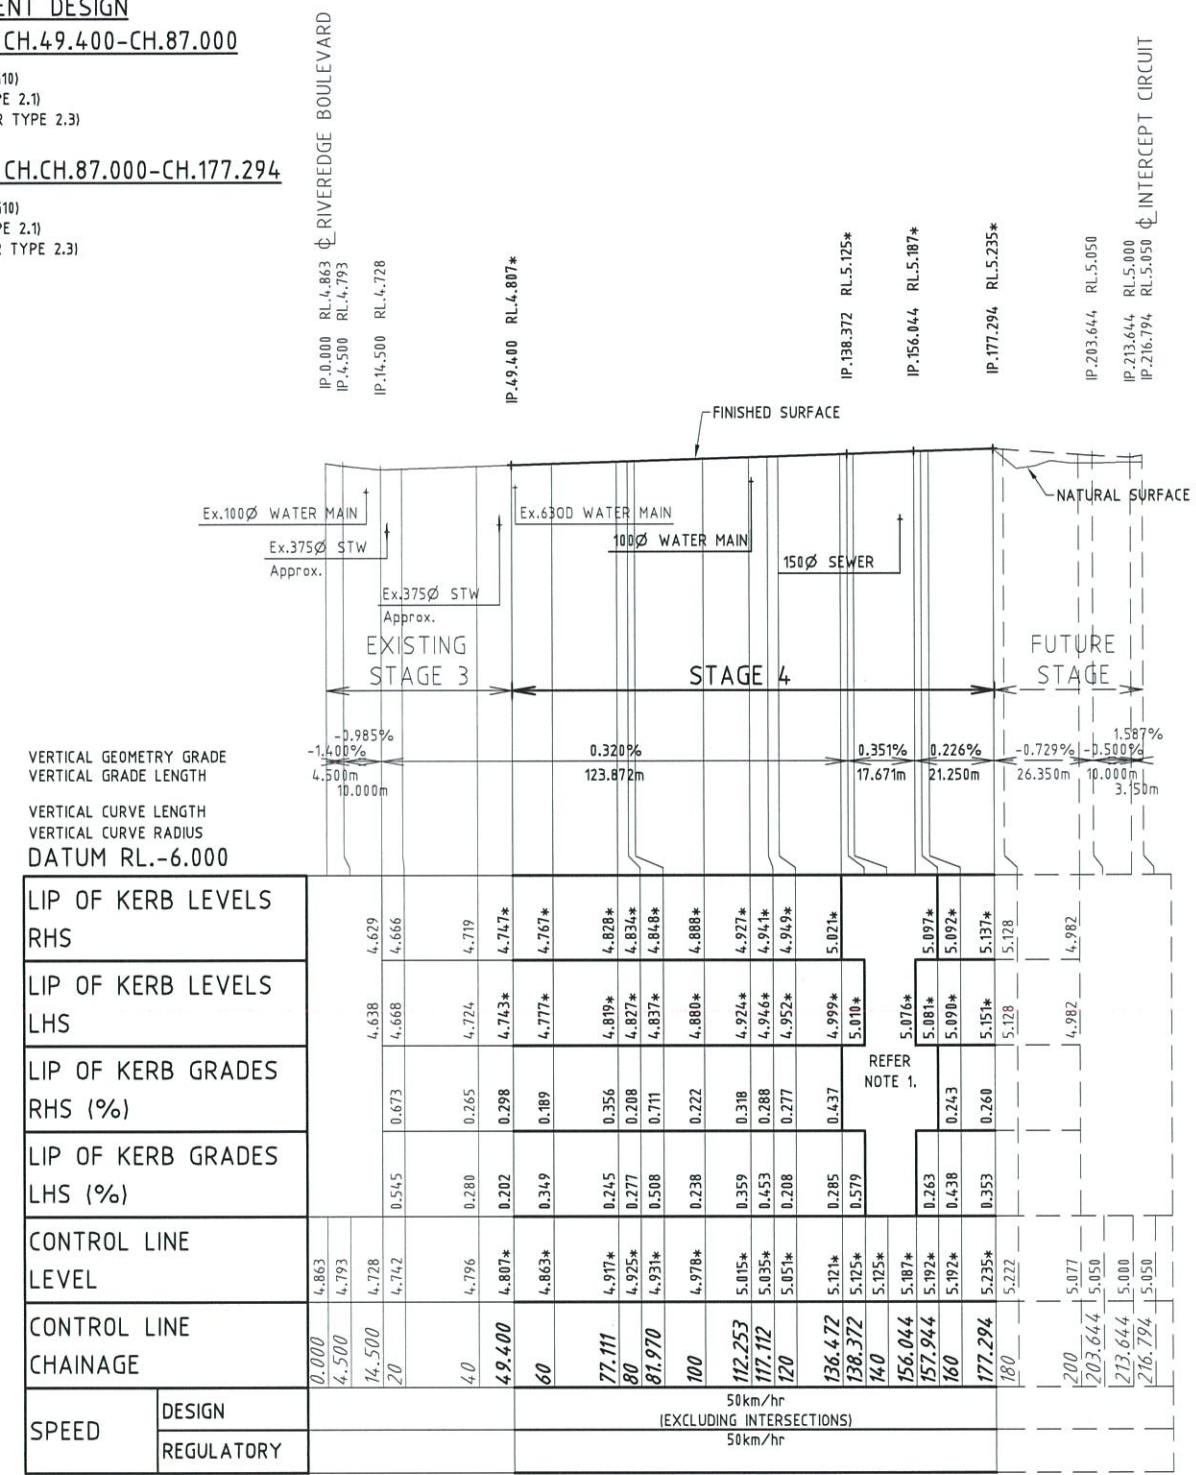

**MAINWARING WAY LONGITUDINAL SECTION**  
 SCALE 1:100 VERTICAL, SCALE 1:1000 HORIZONTAL

**NOTES:**

- REFER ROADWORKS DETAILS PLAN DETAILS.
- FOR ROAD CROSS SECTIONS REFER DRAWING ULD003/105.

**AS-CONSTRUCTED ISSUE**



595 Flinders Street, Townsville  
 Phone: 4772 1144 Fax: 4772 2557  
 Email: townsville@braziermotti.com.au  
 Job No: 29060/048-02

REAL PROPERTY DESCRIPTION:  
 LOTS 400 TO 430, 499 & 9001 CANCELLING LOT 9001 ON SP264450

DRAWN: M.MOTTI  
 DESIGNED:  
 CHECKED: L.SCHAUMBURG  
 PROJECT MANAGER: P.PETERSEN  
 PROJECT DIRECTOR: S.MARTIN RPEQ 9114



Urban Development Design Infrastructure Project Management  
 DELGETY PLACE  
 84 DENHAM STREET  
 PO BOX 1110  
 TOWNVILLE QLD 4810  
 Phone: (07) 4772 0666  
 Fax: (07) 4772 0566  
 Email: main@udpconsulting.com.au  
 Web: www.udpconsulting.com.au

ECONOMIC DEVELOPMENT QUEENSLAND

THE VILLAGE - STAGE 4  
 RIVEREDGE BOULEVARD, OONONBA  
 MIZUNO VIEW & MAINWARING WAY LONGITUDINAL SECTIONS

DRAWING SIZE	SCALE	AS SHOWN	DRAWING No.	REV
A1	XREF	-	ULD003/104	A

